

COMMISSION
Kathy Castor
Pat Frank
Ken Hagan
Jim Norman
Jan K. Platt
Thomas Scott
Ronda Storms



Administrative Offices,
Legal & Water Management Division
The Roger P. Stewart Environmental Center
1900 - 9th Ave. • Tampa, FL 33605
Ph. (813) 272-5960 • Fax (813) 272-5157
Air Management Fax 272-5605
Waste Management Fax 276-2256
Wetlands Management Fax 272-7144
1410 N. 21st Street • Tampa, FL 33605

Executive Director
Richard D. Garrity, Ph.D.

August 23, 2004

Mr. Dave Develder
Shadow Run Dam Corp.
P.O. Box 980
Tampa, FL 33568

SUBJECT: EPC REVIEW OF AN APPLICATION TO PERFORM MISCELLANEOUS ACTIVITIES IN WETLANDS / NUISANCE AND EXOTIC VEGETATION REMOVAL FOR SHADOW RUN DAM CORP. AT THE SOUTHWEST FLORIDA WATER MANAGEMENT DISTRICT'S MITIGATION SITE / PROPERTY LOCATED EAST OF DONNEYSMOOR DRIVE AND WEST OF THE DAM AT BELL CREEK / FOLIO #76828.5558 / APPLICATION RECEIVED 07-22-04 / EXPIRATION DATE: 08-20-07 / STR 26-30-20

Dear Mr. Develder:

The staff of the Environmental Protection Commission (EPC) has completed its review of your request to remove nuisance vegetation from the subject wetland. The EPC grants authorization to remove nuisance vegetation within the wetland under the following conditions:

1. EPC staff will authorize the removal of the following nuisance species from within the 150 linear feet of the Wetland Conservation Area of Lake Grady indicated on the subject plan submittal:


Common Name	Scientific Name	Method of Control
Torpedo grass	<i>Panicum repens</i>	Approved herbicide
cattails	(<i>Typha spp.</i>)	Approved herbicide
paragrass	<i>Brachiaria mutica</i>	Approved herbicide
Alligator weed	<i>Alternanthera philoxeroides</i>	Approved herbicide
Primrose willow	(<i>Ludwigia spp.</i>)	Approved herbicide

2. The site must be re-vegetated as stated within the 'Forested Mitigation Area A-A' planting plan and the 'Herbaceous Mitigation Area B-B' replanting plan. Both plans are incorporated as part of this permit. (attached)
3. The area must be replanted no later than 60 days from date of this letter.
4. There must be at least 85% survival of plants within revegetation zones 180 days after planting; otherwise additional plantings will be required until 85% survival is achieved. Additional planting (if needed) will start the 180-day monitoring period over again.

www.epchc.org

E-Mail: epcinfo@epchc.org

AN AFFIRMATIVE ACTION - EQUAL OPPORTUNITY EMPLOYER

 Printed on recycled paper

5. Vegetation removal must occur by hand, or through the use of hand held equipment. No heavy equipment will be allowed within the Wetland Conservation Area. EPC staff will not object to the use of an approved herbicide in the removal of the nuisance species. Any herbicide proposed for use must be approved for use in aquatic systems by the Environmental Protection Agency (EPA), and must be applied in accordance with label directions.
6. This approval does not provide approval for any dredging or muck removal for this site.
7. All debris must be taken off site to an acceptable disposal facility. No fill (plant debris or soil) may be placed within the wetlands on site.

INFORMATIONAL COMMENTS/CONDITIONS

- **This approval letter, or a copy of this approval letter, must be present on-site during permitted activities.** This authorization is valid for two years from this date. The permit holder may renew it for one additional year upon favorable review by EPC staff and upon written request, during the last month of the permit's valid period.
- This approval applies only to the development proposal as submitted, and in no way does it provide EPC approval to any other aspect of the EPC review process. In addition, this approval does not imply exemption from obtaining all proper permits from other governmental agencies.
- Any activity interfering with the integrity of a wetland, such as clearing, excavating, draining or filling, without written authorization from the Executive Director of the EPC or his authorized agent, pursuant to Section 1-11.07, Rules of the Commission, would be a violation of Section 17 of the Environmental Protection Act of Hillsborough County, Chapter 84-446, and of Chapter 1-11, Rules of the EPC.

If you have any questions or concerns, please do not hesitate to contact me at 813-272-5960, extension 1225.

Sincerely,








Evelyn Jenne
Environmental Scientist
Wetlands Management Division
Environmental Protection Commission
of Hillsborough County

cc: EPC Compliance Files
Mr. Mark Bossard, Lake Doctors


ej/pda/lh

THE LAKE DOCTORS, INC
 10840 76th Court North
 Largo, Florida 33777
 (727) 544-7644 Fax (727) 541-2493
 1-800-444-5253

EXPLANATION	
	SOFT RUSH (<i>JUNCUS effusus</i>) 60 - 1 Gallon Plants, 3 ft. o.c.
	PICKERELWEED (<i>PONTERDERIA cordata</i>) 60 - 1 Gallon Plants, 3 ft. o.c.
	ARROWHEAD (<i>SAGITTARIA lancifolia</i>) 60 - 1 Gallon Plants, 3 ft. o.c.
	SPATTERDOCK (<i>NUPBAR tuteum</i>) 100 - 1 Gallon Plants, 3 ft. o.c.

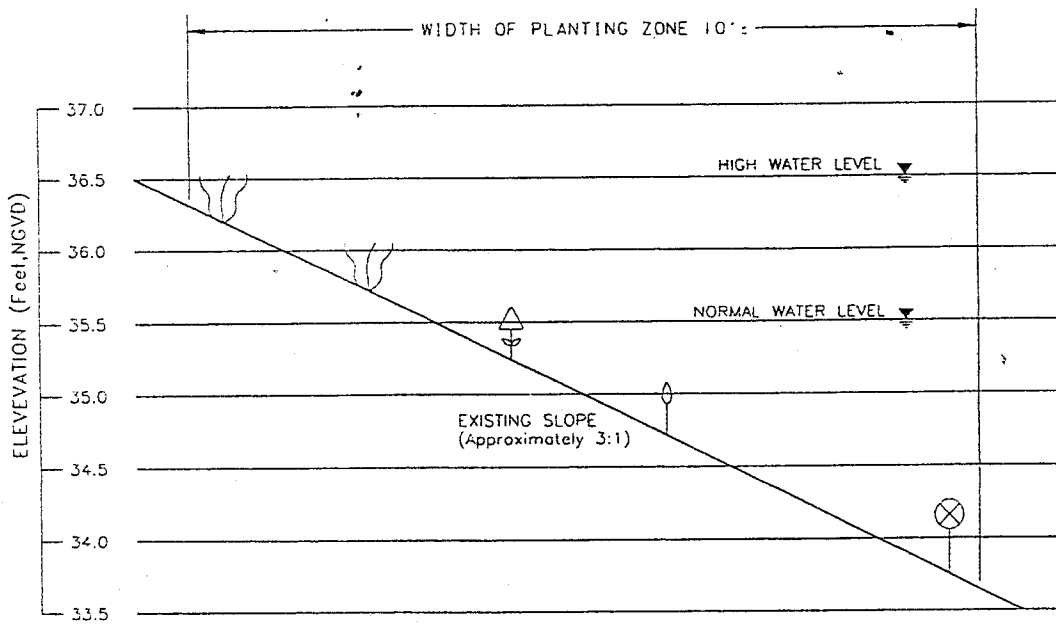

HERBACEOUS MITIGATION AREA B-B

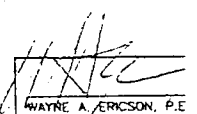
 WAYNE A. ERICSON, P.E.
 FLA. REG. NO. 34125
 DATE: 5/15/97



AS-BUILT/RECORD DRAWING


NAME	DATE	NAME	DATE
DRAWN BY: KMC	5/97	DRAWN BY: LBD	5/97
CHECKED BY: KMC	5/97		

LAKE GRADY
 APPROVED BY: _____ DATE: _____

**CONTROL STRUCTURE
 MITIGATION SECTIONS**

THE LAKE DOCTORS, INC
 10840 76th Court North
 Largo, Florida 33777
 (727) 544-7644 Fax (727) 541-2493
 1-800-444-5253

EXPLANATION	
	RED MAPLE (<i>ACER rubrum</i>) 8 - 3 Gallon Trees, 10 ft. o.c.
	BALD CYPRESS (<i>TAXODIUM distichum</i>) 8 - 3 Gallon Trees, 10 ft. o.c.

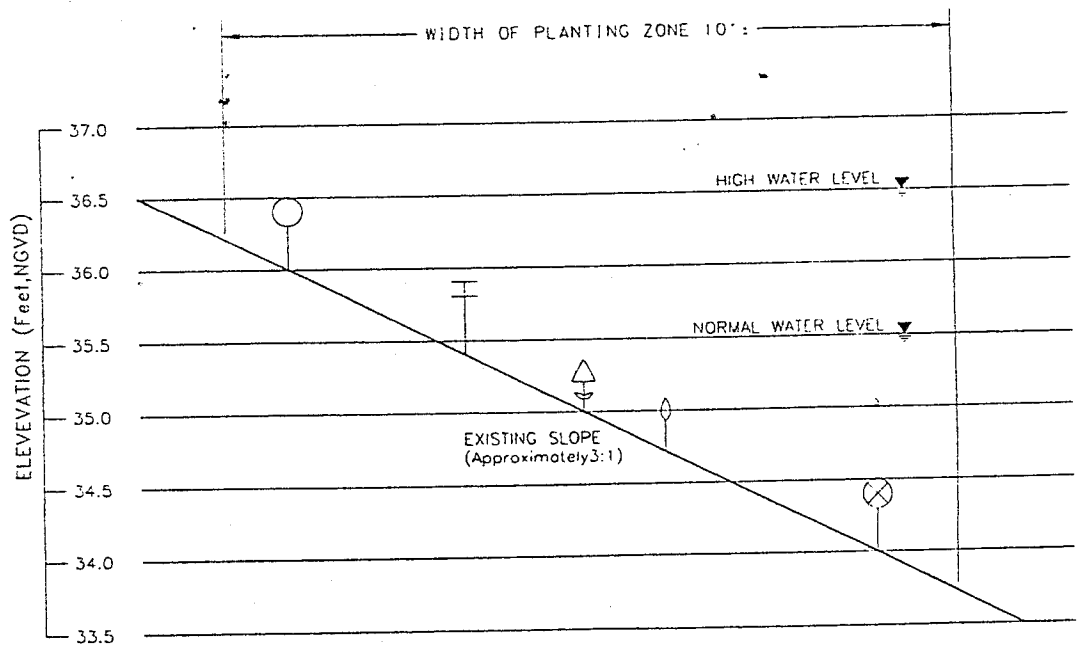

FORESTED MITIGATION AREA A-A

C:\P\08\9406\STRUCTURE\8406M12.DWG

REVISIONS								
DATE	BY	DESCRIPTION	DATE	BY	DESCRIPTION	DATE	BY	DESCRIPTION
5-00	BJR	AS-BUILT						

BC
ENGINEERS & SCIENTISTS
 2000 E. EDGEWOOD DRIVE, LAKELAND,
 FLORIDA 34141
 PHONE: (813) 667-2345